

Recommended Run Times (minutes)

- Spray – Shrub 12
- Spray – Lawn 25
- Rotor – Lawn 45
- Drip – Lawn 45

Recommended Monthly Cycles

(Water Days)

- January 3
- February 3
- March 4
- April 4
- May 7
- June 9
- July 11
- August 11
- September 9
- October 6
- November 4
- December 3

Recommended Maintenance

- Backflow – Test Annually
- Filter – Check Annually for debris
- Heads – Run system monthly checking for leaks or broken heads
- Valve Covers – Trim grass to keep exposed
- Controller – Seasonal update programming
- Winter – Run system briefly every 2 weeks if system turned off


Legend

- ⊗ Backflow
- ▲ Controller
- ⊗ Control Valve
- Spray - Shrub
- Spray - Lawn
- ▼ Rotor - Lawn
- B Bubbler
- Drip Tubing
- - - Main Line

COMPLETION ITEMS PROVIDED

- The manufacturer's manual for the controller.
- A seasonal watering schedule.
- A list of components that require maintenance and the recommended frequency of maintenance.
- A permanent sticker has been attached to the controller indicating the warranty period for the irrigation system and contact information.
- The corrected or re-drawn design plans indicating the actual installation and components of the system.
- Location and operation of the isolation valve.

Best of Texas
Landscapes

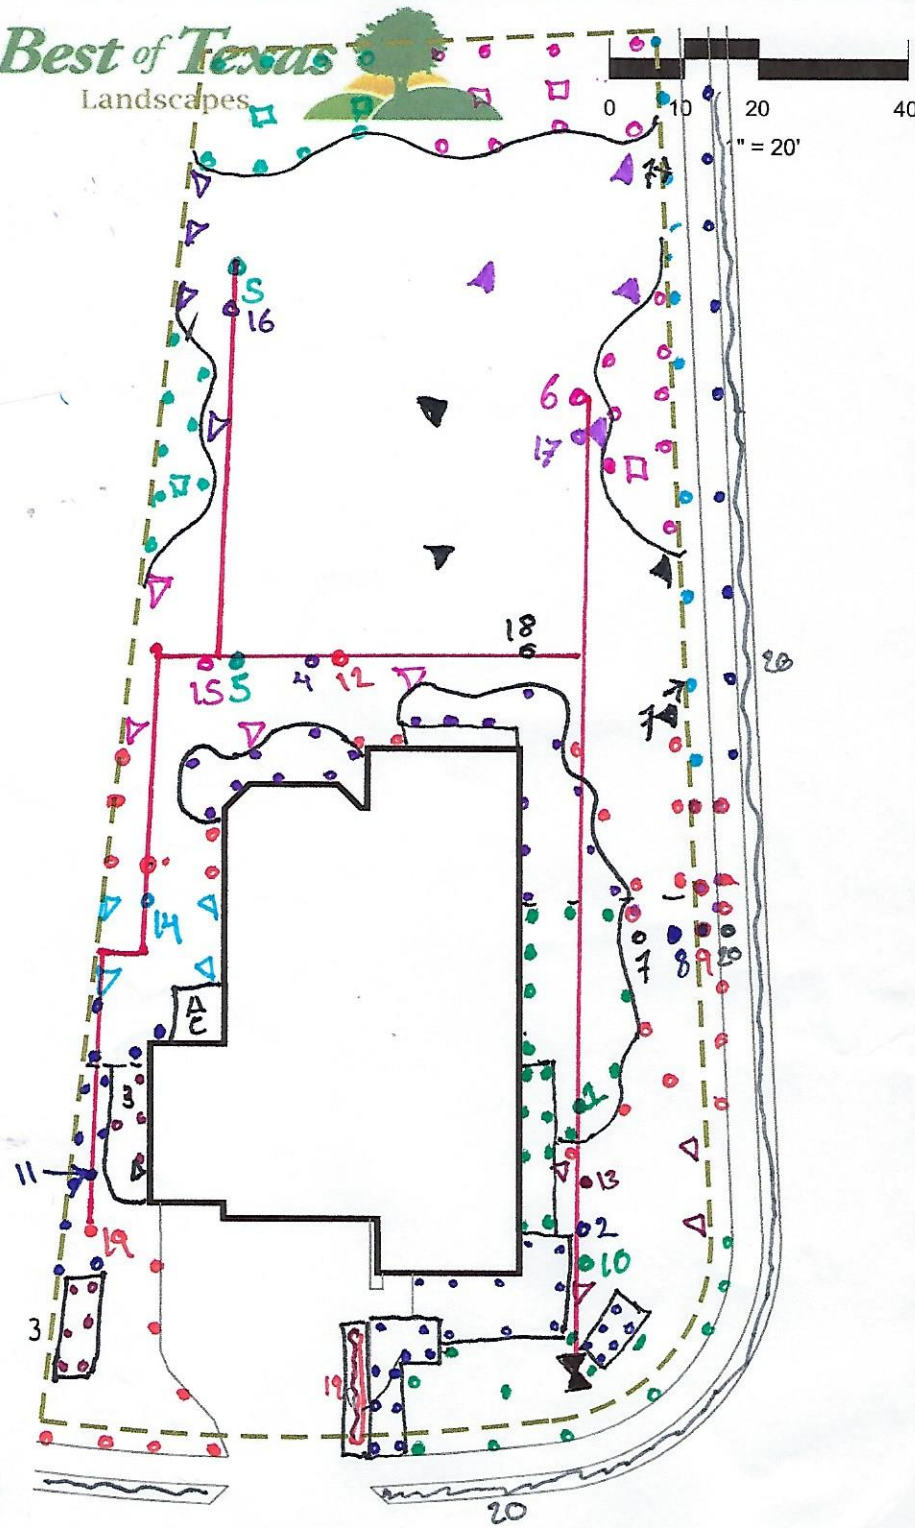

2605 ROARING RIVER TRAIL

This irrigation system has been installed in accordance with all applicable state and local laws, ordinances, rules, regulations or orders. I have tested the system and determined that it has been installed according to the irrigation plan and is properly adjusted for the most efficient application of water at this time.

System Owner / Representative _____ Date _____

[Signature]

10.3.2024

NOTE: ALL Piping shown is diagrammatic and NOT illustrating actual location.



DATE:	10.3.2024
JOB NUMBER:	78641ROAR2805
DRAWN BY:	CARTER
CHECKED BY:	STUBBLEFIELD
SCALE:	1" = 20'
SHEET:	1 of 1

PROJECT:	2605 ROARING RIVER TRAIL LEANDER, TX 78641
REVISIONS:	COMPLETION:
	LOT A BLOCK 29 LOST WOODS RESERVE

SHEET DESCRIPTION:	IRRIGATION PLAN

COMPANY:	BEST OF TEXAS LANDSCAPES LIBERTY HILL, TEXAS 78642
	(512) 260-1430
	www.bestoftexaslandscapes.com